


CHRISTIE'S  
INTERNATIONAL REAL ESTATE


— COSTA DEL SOL —

Floor plans


# PLANTA SOTANO CONFORME A OBRA

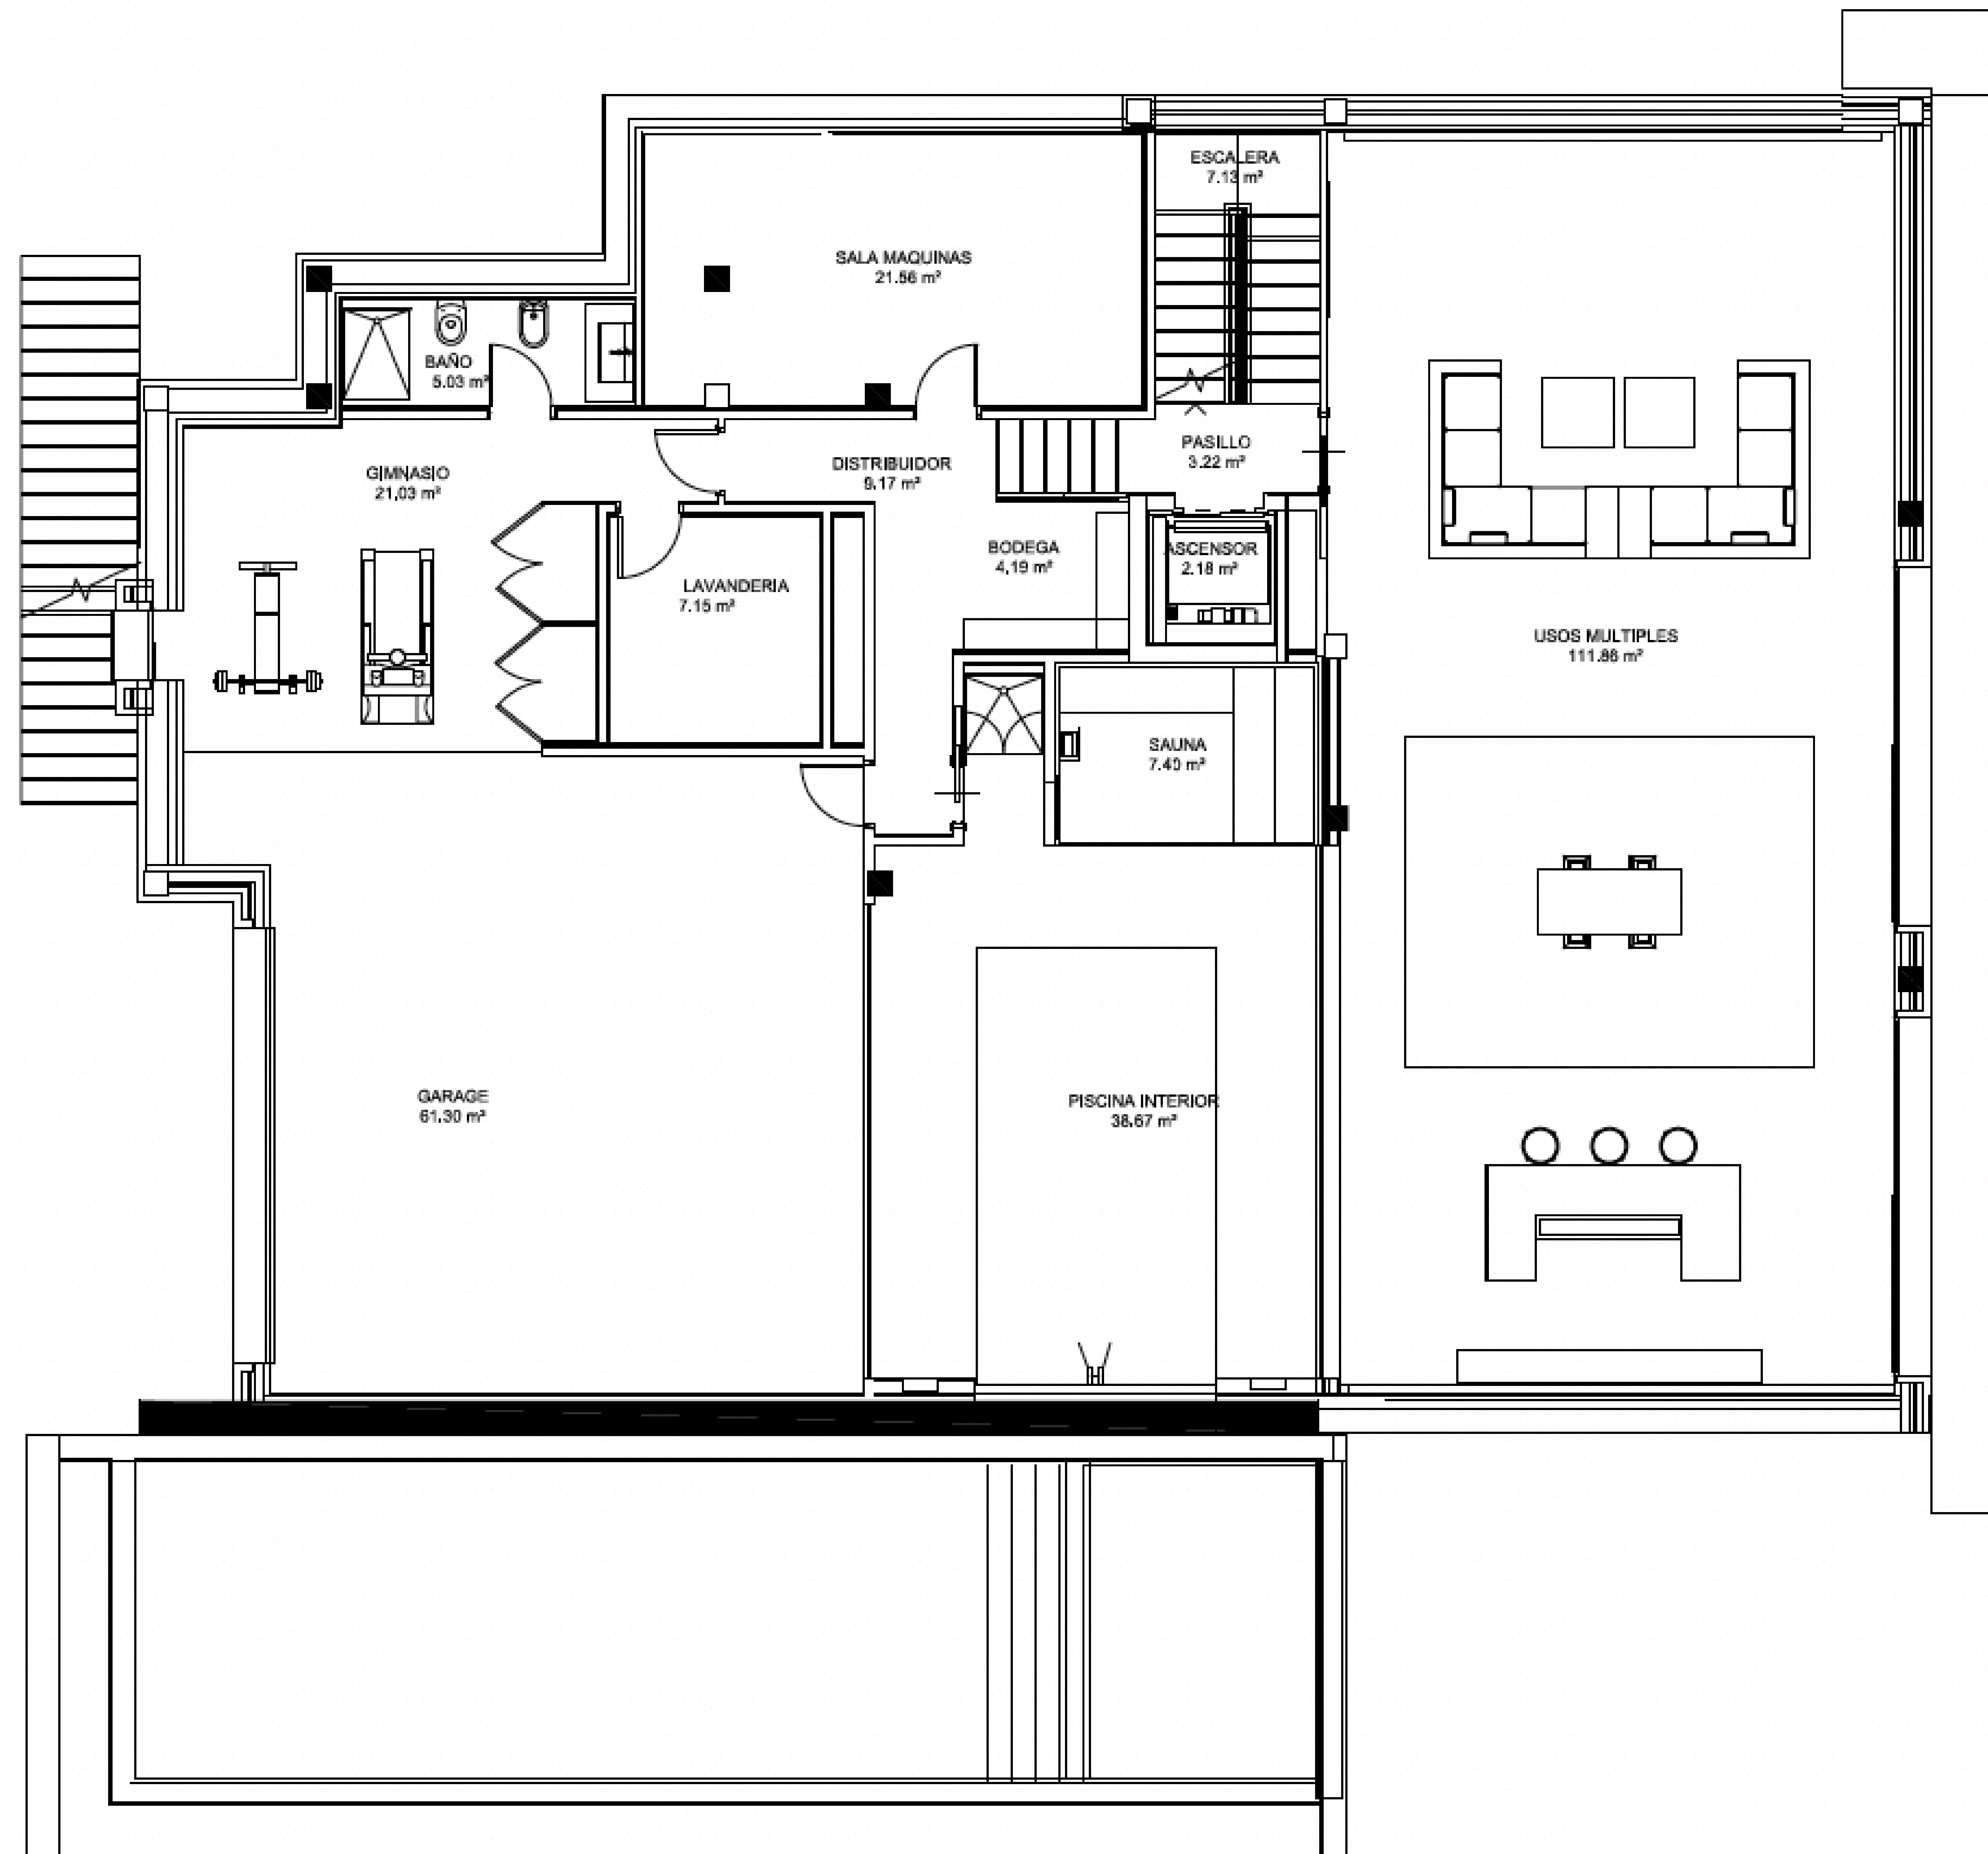

# PLANTA BAJA CONFORME A OBRA

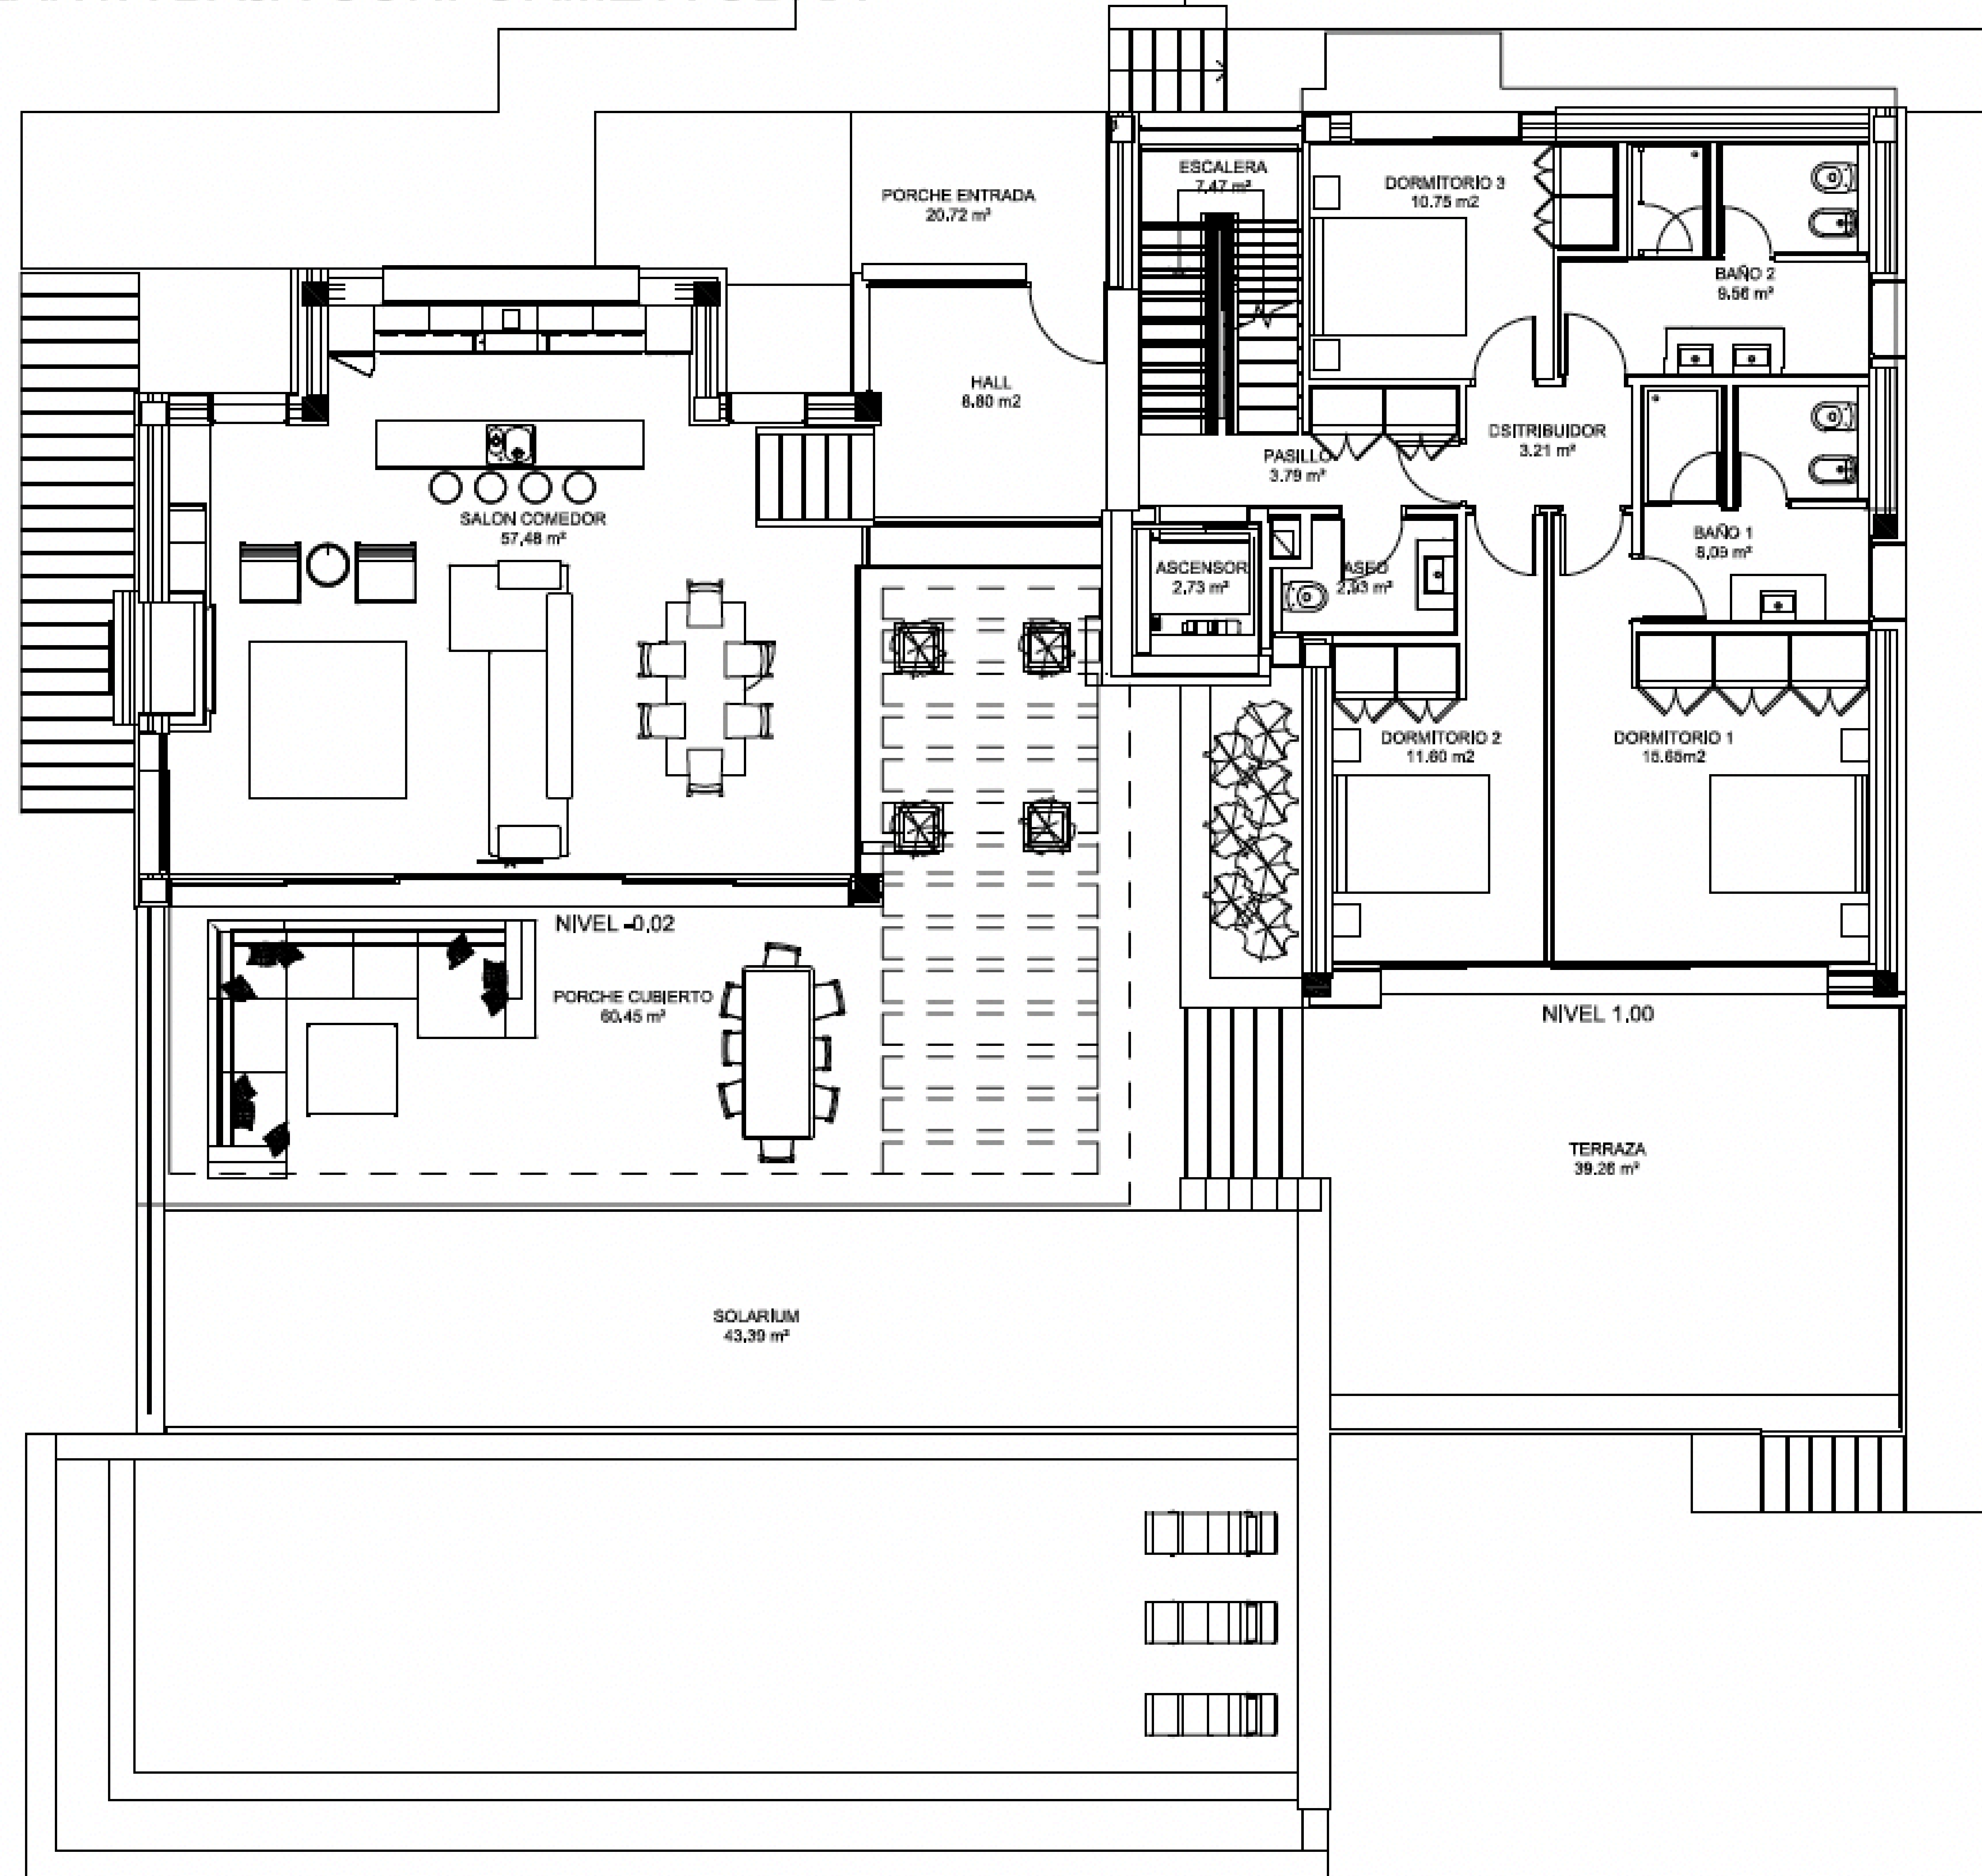

# PLANTA ALTA CONFORME A OBRA

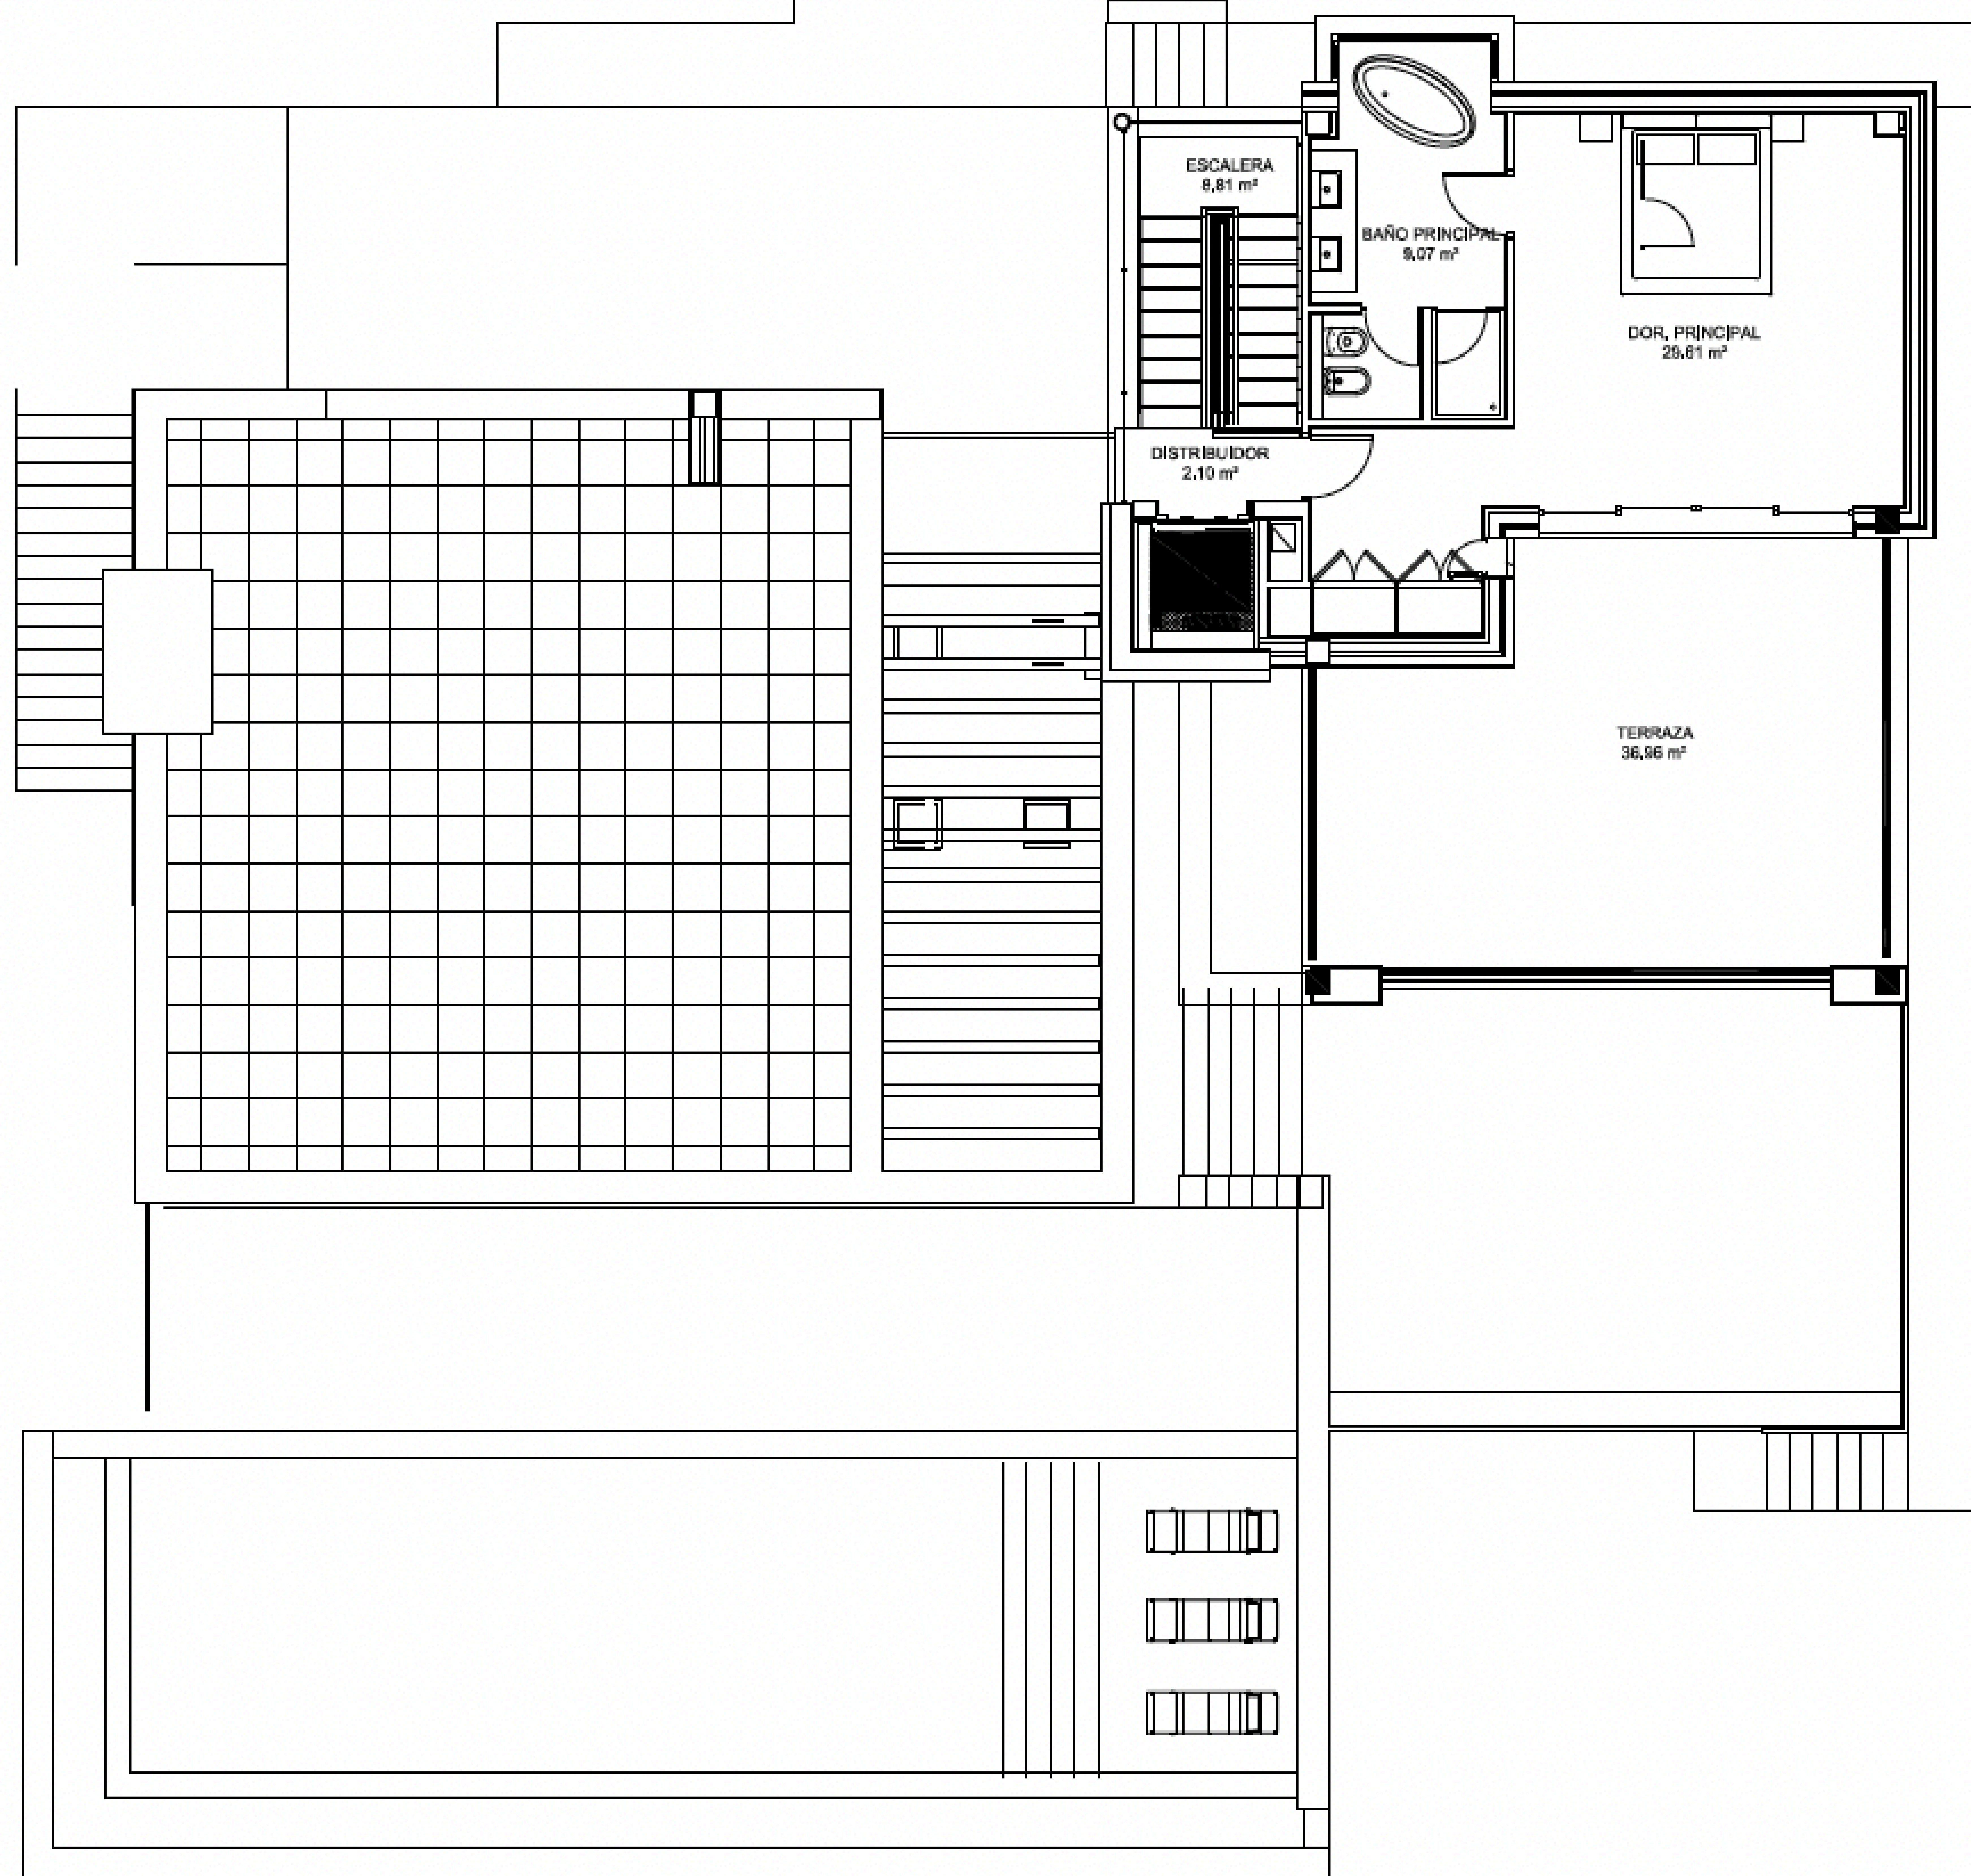

CHRISTIE'S  
INTERNATIONAL REAL ESTATE  
———— COSTA DEL SOL ————

Where *Luxury* lives

Velázquez, 1, 29602 Marbella, España  
+34 951 122 313 | marbella@cire-costadelsol.com

Paseo de Reding, 25, 29016 Málaga, España  
+34 951 122 312 | malaga@cire-costadelsol.com